

408 Permit Request

Type of Modification:

Date:

Location Information

Decimal Latitude:

Decimal Longitude:

State:

County:

Nearest Town:

Owner Information

Federal Project Owner:

Owner's Approving Representative:

Phone No.:

Requestor

Name:

Firm:

Phone No.:

Email:

Address:

Engineer of Record

Name:

Firm:

Phone No.:

Email:

Address:

Brief Description of Proposed Modification:

Reason for Modification:

Impact on System Integrity:

Impact on System Operation and Maintenance:

Proposed Construction Start: End:

For Internal Use

From Rev 20120222

Levee System Number:

Levee Segment Number:


Approved Date:

TEST PIT SECTION

SCALE: 1"=10'-0"


TEST PIT / PERCOLATION TEST

- RESTORE DRAINAGE LAYER AFTER DISTURBANCE. BACKFILL CAP MATERIAL.

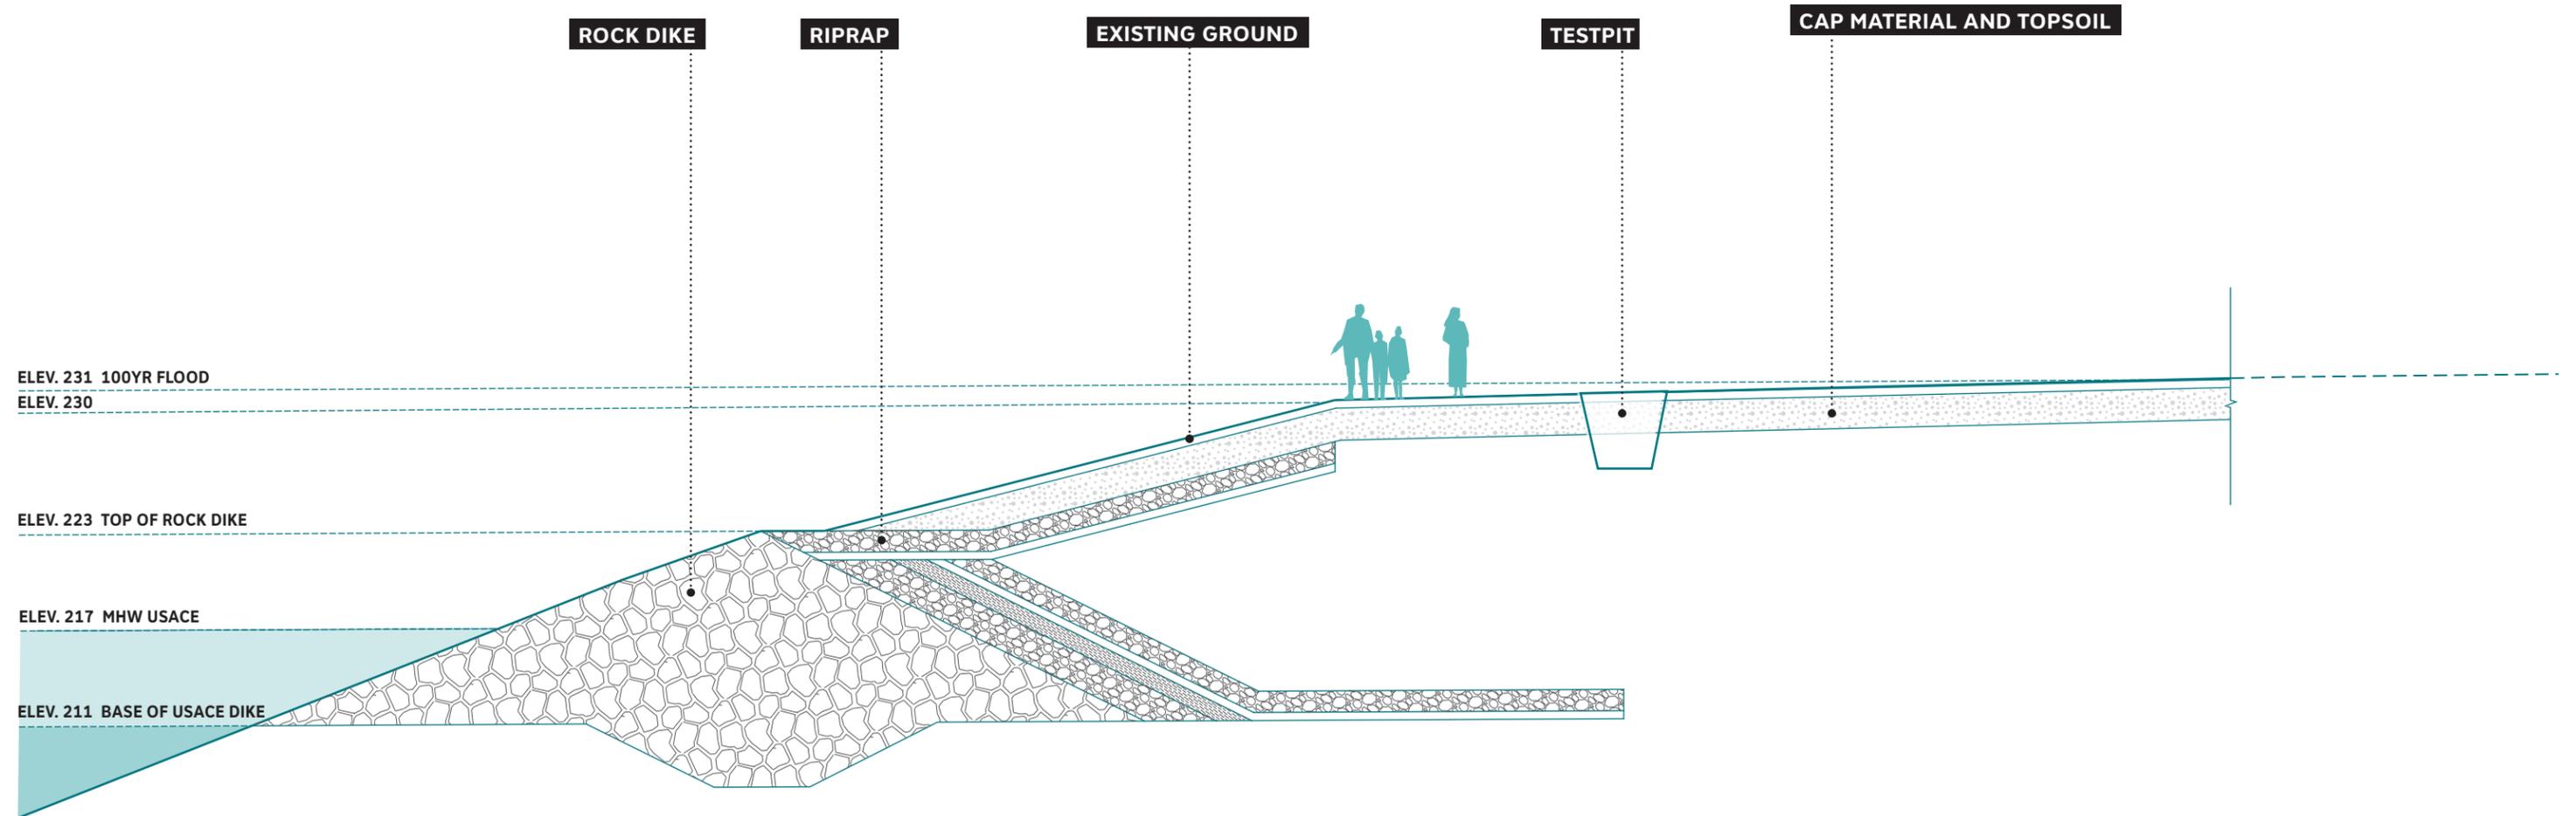

PHASE III ENGINEERS SECTION

NOTE: TOP SOIL SHOWN ON THIS SHEET AND CROSS SECTION SHEETS 4 THRU 25 IS NOT A PART OF THIS CONTRACT.

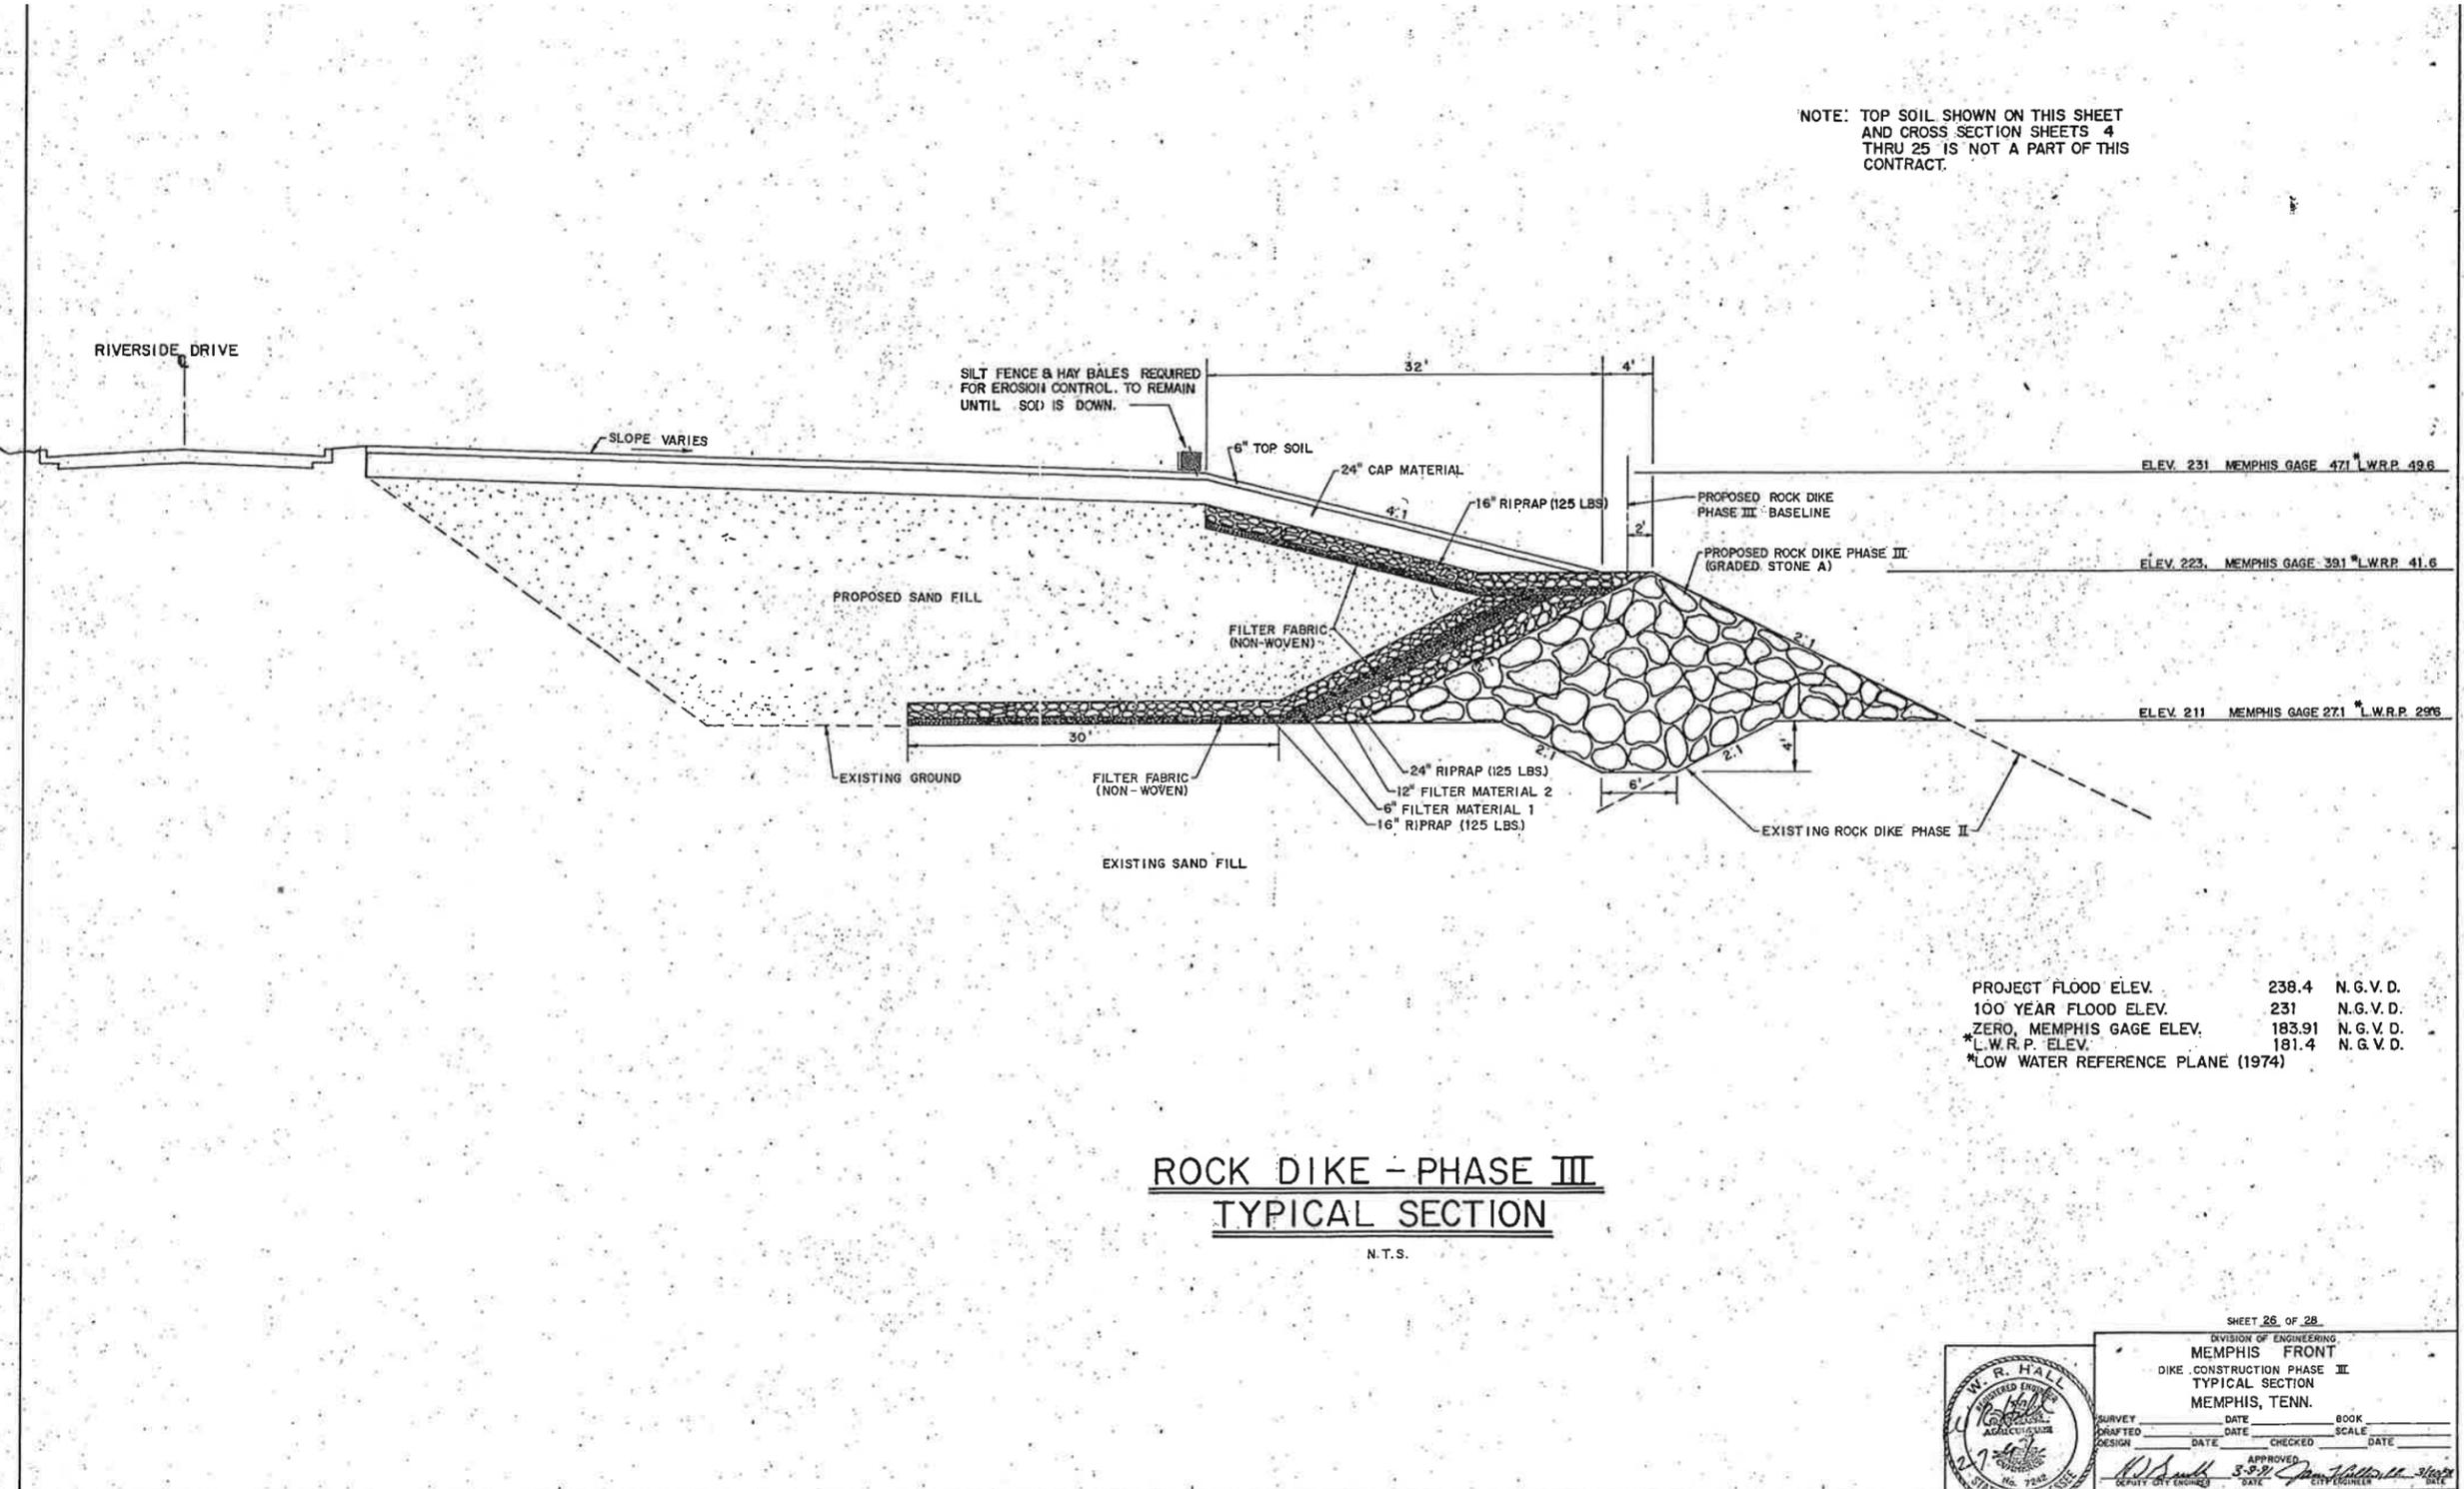

PROJECT FLOOD ELEV.	238.4	N.G.V.D.
100 YEAR FLOOD ELEV.	231	N.G.V.D.
ZERO, MEMPHIS GAGE ELEV.	183.91	N.G.V.D.
*L.W.R.P. ELEV.	181.4	N.G.V.D.
*LOW WATER REFERENCE PLANE (1974)		

ROCK DIKE - PHASE III TYPICAL SECTION

N.T.S.

SHEET 26 OF 28

DIVISION OF ENGINEERING
MEMPHIS FRONT
DIKE CONSTRUCTION PHASE III
TYPICAL SECTION
MEMPHIS, TENN.

SURVEY	DATE	BOOK	SCALE
DRAFTED	DATE	CHECKED	DATE
DESIGN	DATE	APPROVED	DATE



DEPUTY CITY ENGINEER

MICROFILMED

GEOTECH BORING MAP

Boring Location Plan

PSI Proposal 0502-262040

SCAPE MARKUP
OF PSI
PROPOSAL FOR
USACE
APPROVAL

